






Front Elevation 1:100

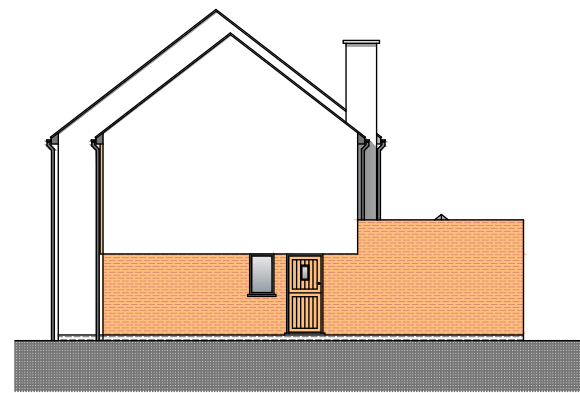

Side Elevation to no.10 1:100

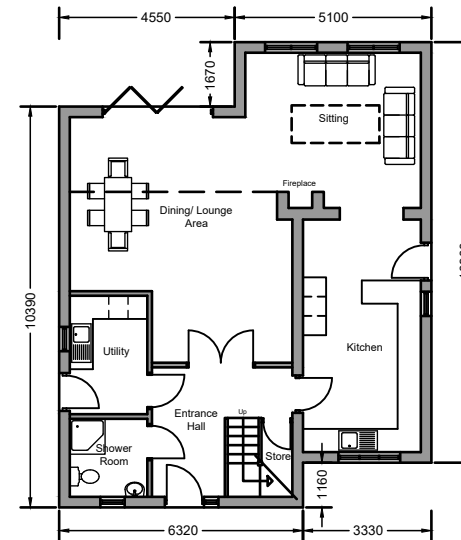


Ground Floor Plan 1:100

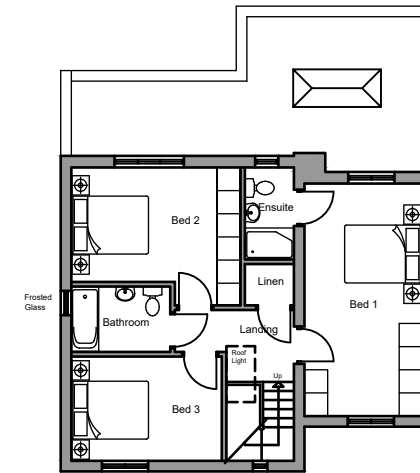


First Floor Plan 1:100



Rear Elevation 1:100

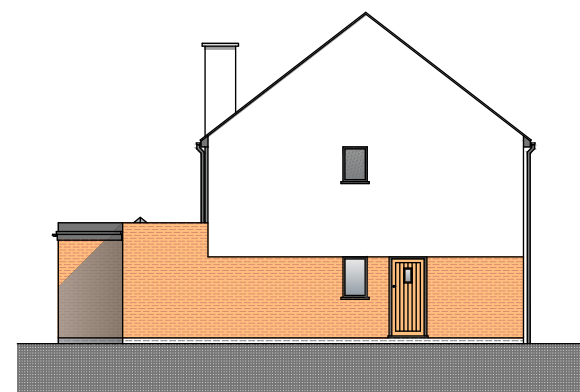

Side Elevation to no.6 1:100

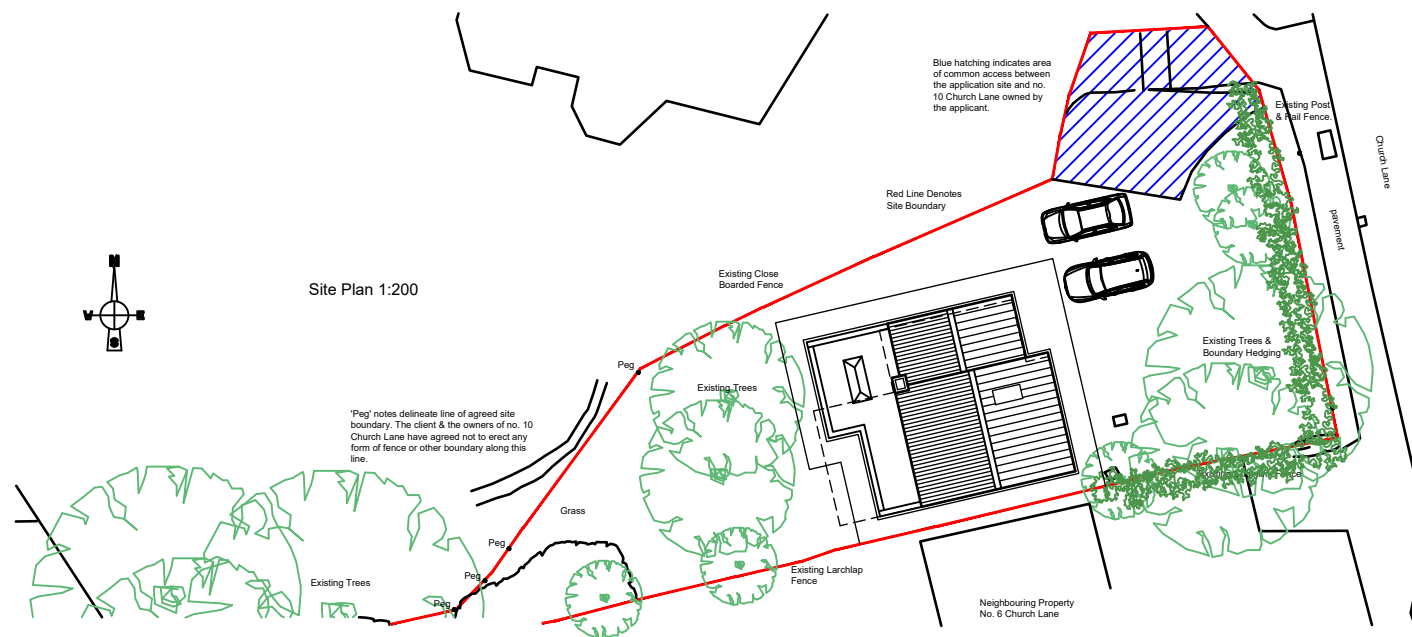

Site Plan 1:200

REVISIONS



**Cinnabar**

8 : White St : Kibworth Beauchamp :  
Leicestershire : LE8 0JG  
E : theoffice@cinnabar-cad.co.uk  
W : www.cinnabar-cad.co.uk  
T : 0116 2796605 M : 07808 732119

CLIENT:  
A CLIENT

BUILDING:  
A BUILDING  
AN ADDRESS  
AN ADDRESS  
A COUNTY  
12AB 3CD

FLOOR:  
N/A

DRAWING TITLE:  
NEW DWELLING  
AS BUILT LAYOUT &  
ELEVATIONS

SCALE @ 1:1, A1: N.T.S DATE: NOV 2020

DRAWN: G.R.W. CHECKED: PROJECT NO:

DRAWING NO. REV: